0 10 20 30

GRAPHIC SCALE

LUMINAIRE SCHEDULE

LUMINAIRE #	GRID COORD.	COMMENTS
1	62.79,2.14	EXISTING FOUNDATION
2	116.07,2.15	EXISTING FOUNDATION
3	161.33,53.99	NEW FOUNDATION
4	22.91,94.90	NEW FOUNDATION
5	22.98,44.90	NEW FOUNDATION
6	30.98,138.65	NEW FOUNDATION

WIRE SCHEDULE

X RUN	RACEWAY CONDUIT SIZE	CONDUCTORS	COMMENTS
1	2"	2-#8	STREET LIGHTING
2	2'	2-#10	STREET LIGHTING

CONSTRUCTION NOTES:

53 SPLICE NEW LIGHTING CONDUCTORS TO EXISTING LIGHTING CONDUCTORS. CONTRACTOR TO VERIFY BREAKER SIZE. REPLACE OR UPSIZE BREAKER IF REQUIRED.

56 INSTALL TYPE 1 JUNCTION BOX.

92 INSTALL FOUNDATION PER STD. DETAIL TRAFFIC-61. PROVIDE AND INSTALL STREET LIGHT POLE PER DETAIL ON THIS SHEET. SEE STD. DETAIL TRAFFIC-50 FOR WIRING DETAILS.

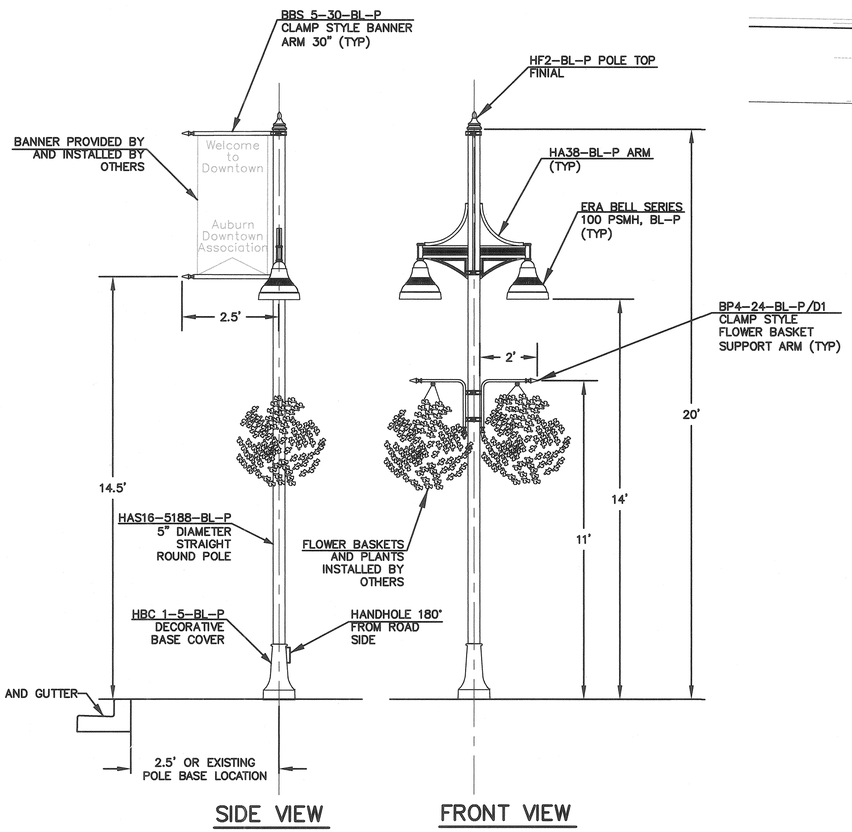

STREET LIGHT POLE DETAIL

NTS

MATCH LINE A SEE SHEET C15

ILLUMINATION LEGEND

EXISTING	PROPOSED	
		LUMINAIRE AND POLE (SEE NOTES FOR TYPE)
		JUNCTION BOX (TYPE 1)
		CONDUIT
		WIRE NOTE
		CONSTRUCTION NOTE

GENERAL NOTES:

1. THE LOCATION OF ALL CONDUIT AND JUNCTION BOXES, SHOWN ON THIS PLAN ARE FOR GRAPHIC PRESENTATION ONLY AND FINAL LOCATION SHALL BE DETERMINED BY THE ENGINEER.
2. SEE STD. DETAIL TRAFFIC-54 FOR CONDUIT TRENCH DETAIL.
3. ALL CONDUCTORS FOR STREET LIGHTS SHALL BE LABELED IN EACH JUNCTION BOX.
4. ALL CONDUIT SHALL BE PVC SCHEDULE 80.
5. ALL CONDUIT SHALL INCLUDE A GROUND WIRE SIZED PER THE N.E.C. (#8 MIN.).
6. SEE ELECTRICAL DRAWINGS FOR SITE LIGHTING IN THE PLAZA. INCLUDING ARTISTIC MONUMENT LIGHTS, UNDER BENCH LIGHTS, FOUNDATION LIGHTING, AND ADA RAMP LIGHTING.

NAVD88

HORIZONTAL DATUM: NAD 83-91 (WASHINGTON NORTH ZONE)

VERTICAL DATUM: NAVD 88

CONTOUR INTERVAL: 0.5 FEET

BURIED UTILITIES IN AREA
PLEASE CALL BEFORE YOU DIG
1.800.424.5555

No.	Date	Revision
1	08/18/2010	ADDENDUM #1

DRAWN TO SCALE, SCALE MAY BE DISTORTED FROM REPRODUCTION

RECORD DRAWING CERTIFICATION

These drawings conform to the Contractor's construction records.

Drawn By: Date

Construction Inspection

	BY	DATE
Drawn	MMC	07/27/2010
Reviewed	EME	07/27/2010
Approved	DS	08/10/2010

SCALE: 1" = 10' n/a

ONE INCH AS DRAWN

File: XXXXX.DWG

DARRELL CHRISTOPHER SMITH STATE OF WASHINGTON 33807 REGISTERED PROFESSIONAL ENGINEER 10-27-10

CITY OF AUBURN WASHINGTON

PUBLIC WORKS DEPARTMENT
25 West Main Street
Auburn, Washington

REVIEWED BY: DATE:

Elizabeth L Chamberlain 11.15.10
Project Manager

Larry Dahl 11/15/10
Construction Manager

Perteet Inc.
425-252-7700 | 1-800-615-9900
2707 Colby Avenue, Suite 900
Everett, Washington 98201

CITY OF AUBURN
CITY HALL PLAZA

SITE CIVIL

ILLUMINATION PLAN & DETAILS
(EXPANDED PLAZA)

PROJECT NUMBER CP0922

CONTRACT NUMBER 10-24

DRAWING NUMBER C22

SHEET 22 OF 57

Oct 22, 2010 - 4:03pm mjain C:\Vault Working\20100050 - Auburn City Hall Plaza\Cad\Cadd\Plots\20100050 - Illumination Plan.dwg Layout Name: illumination detail